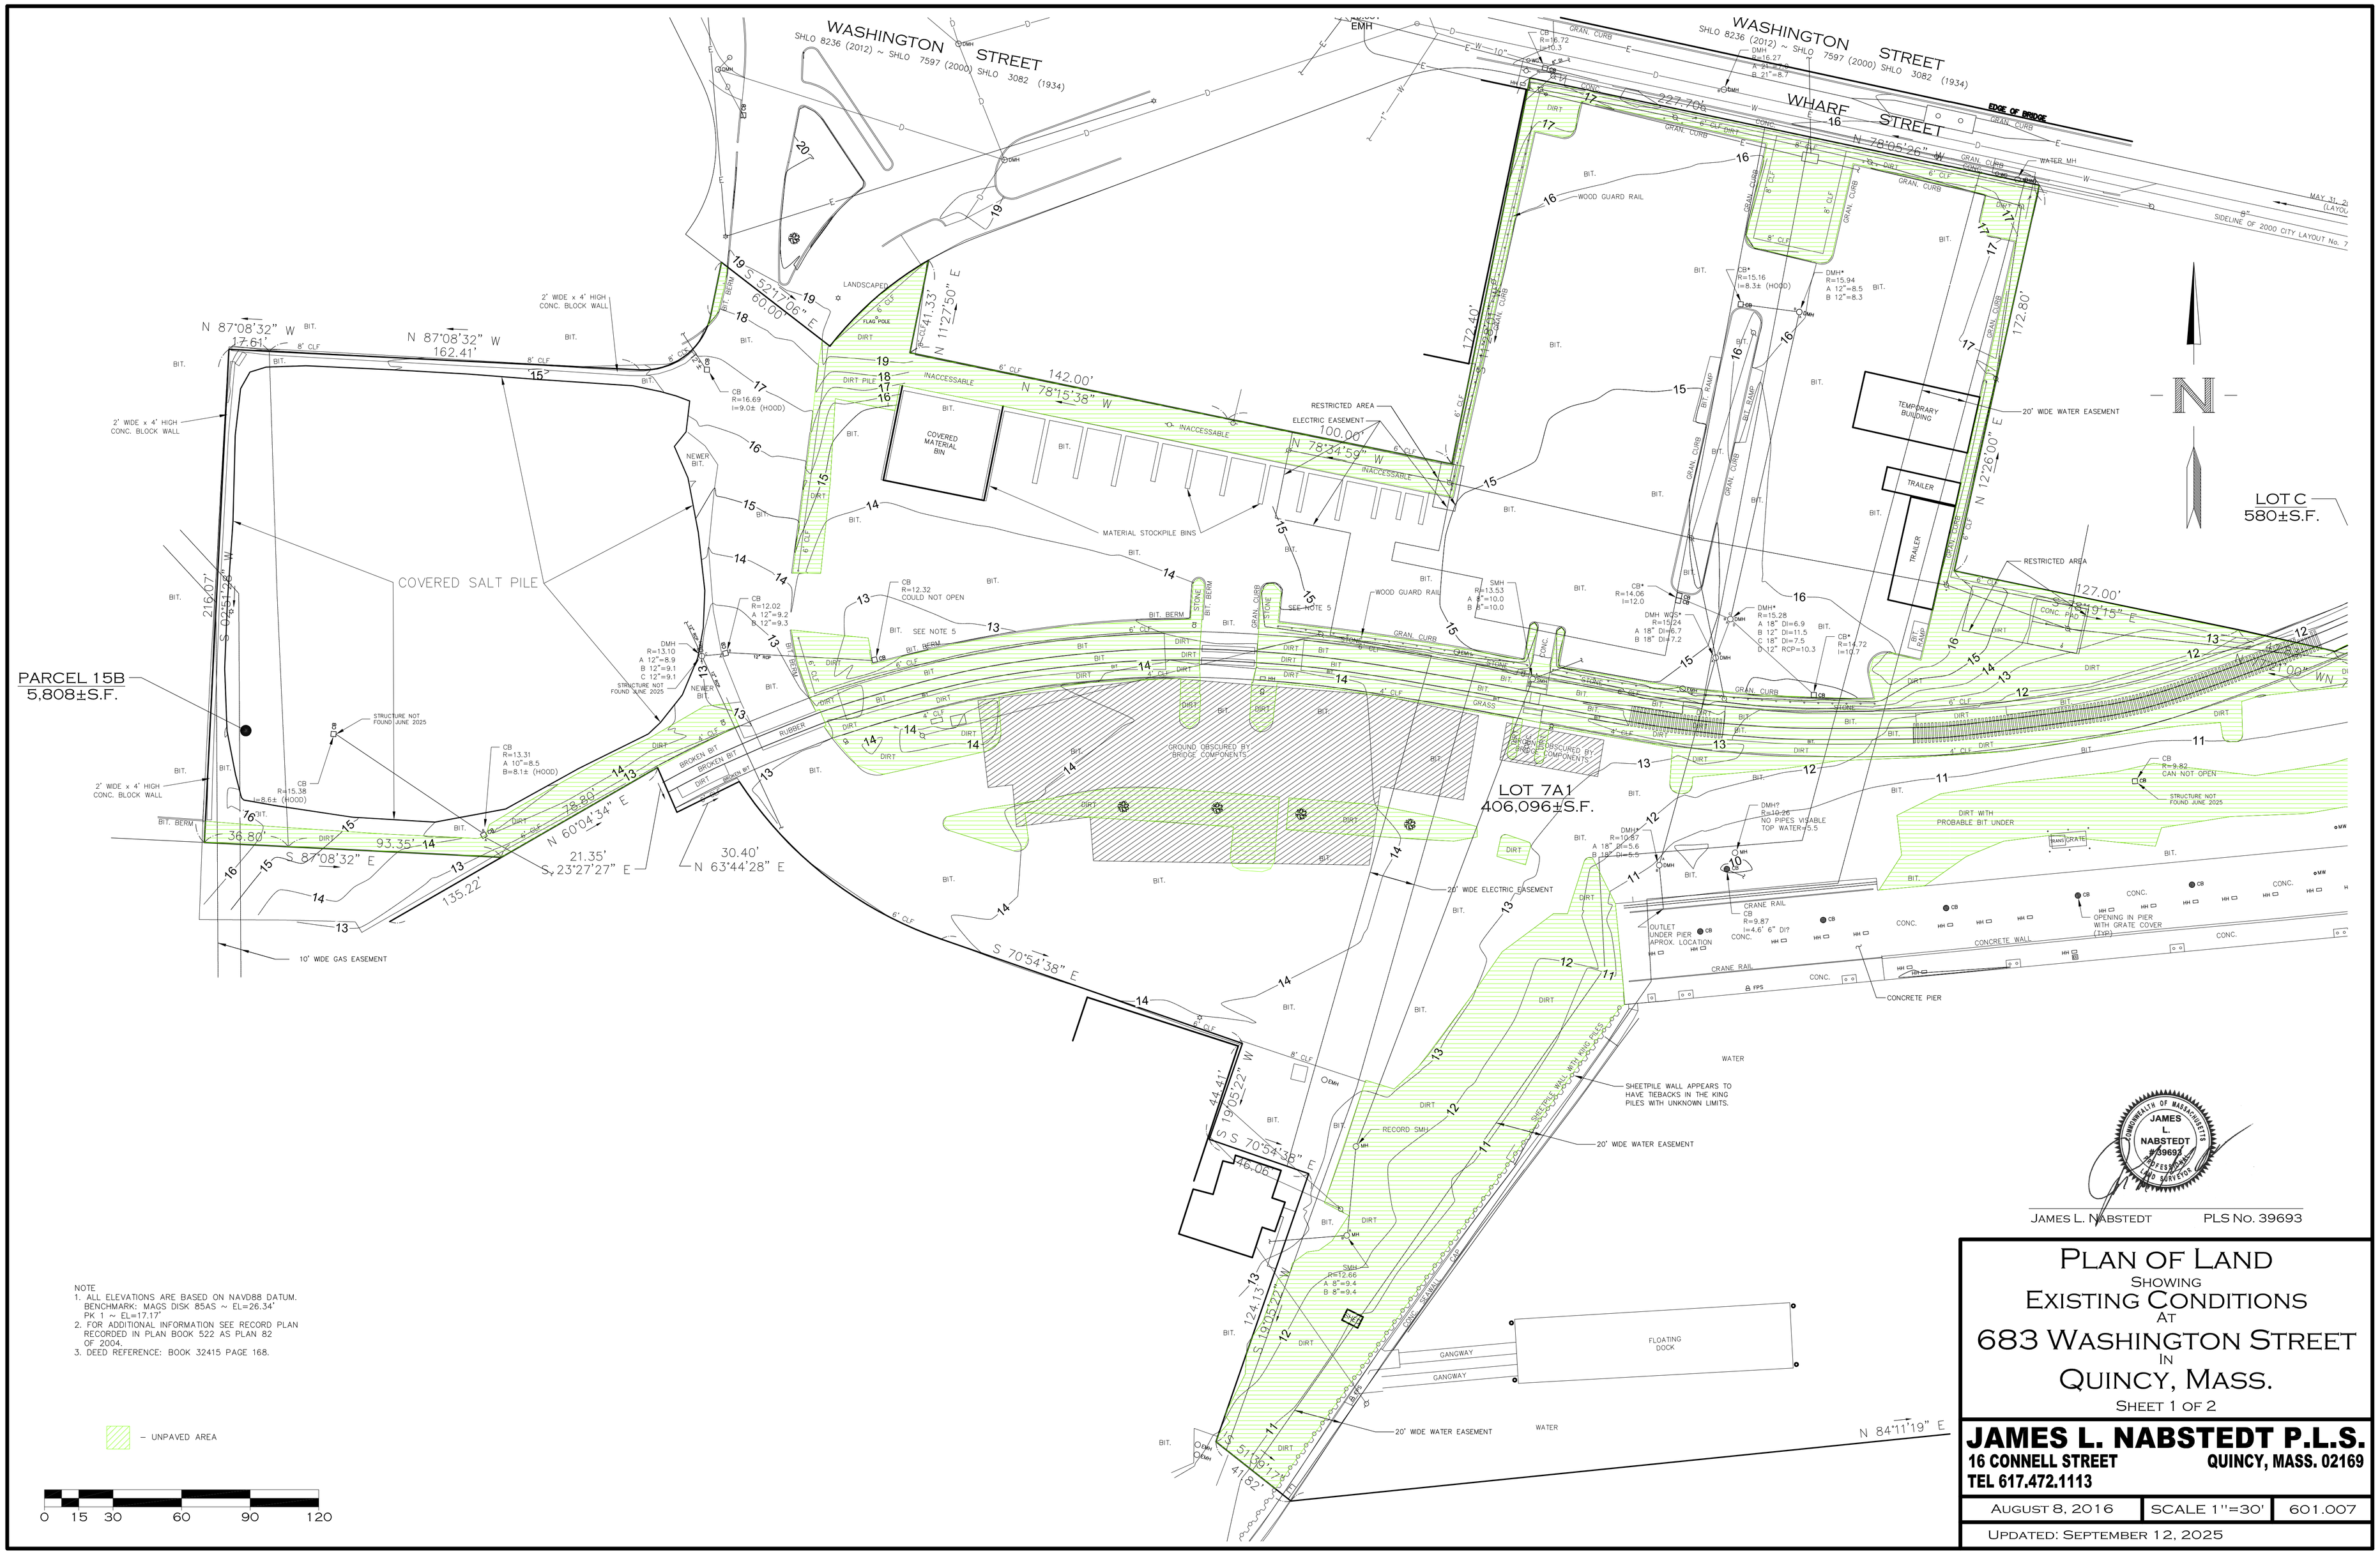

NOTE
1. ALL ELEVATIONS ARE BASED ON NAVD88 DATUM. BENCHMARK: MAGS DISK 85AS ~ EL=26.34' PK 1 ~ EL=17.17'
2. FOR ADDITIONAL INFORMATION SEE RECORD PLAN RECORDED IN PLAN BOOK 522 AS PLAN 82 OF 2004.
3. DEED REFERENCE: BOOK 32415 PAGE 168.

– UNPAVED AREA

0 15 30 60 90 120

JAMES L. NABSTEDT PLS No. 39693

PLAN OF LAND
SHOWING
EXISTING CONDITIONS
AT
683 WASHINGTON STREET
IN
QUINCY, MASS.
SHEET 1 OF 2

JAMES L. NABSTEDT P.L.S.
16 CONNELL STREET QUINCY, MASS. 02169
TEL 617.472.1113

AUGUST 8, 2016	SCALE 1"=30'	601.007
UPDATED: SEPTEMBER 12, 2025		